Atwood Architecture

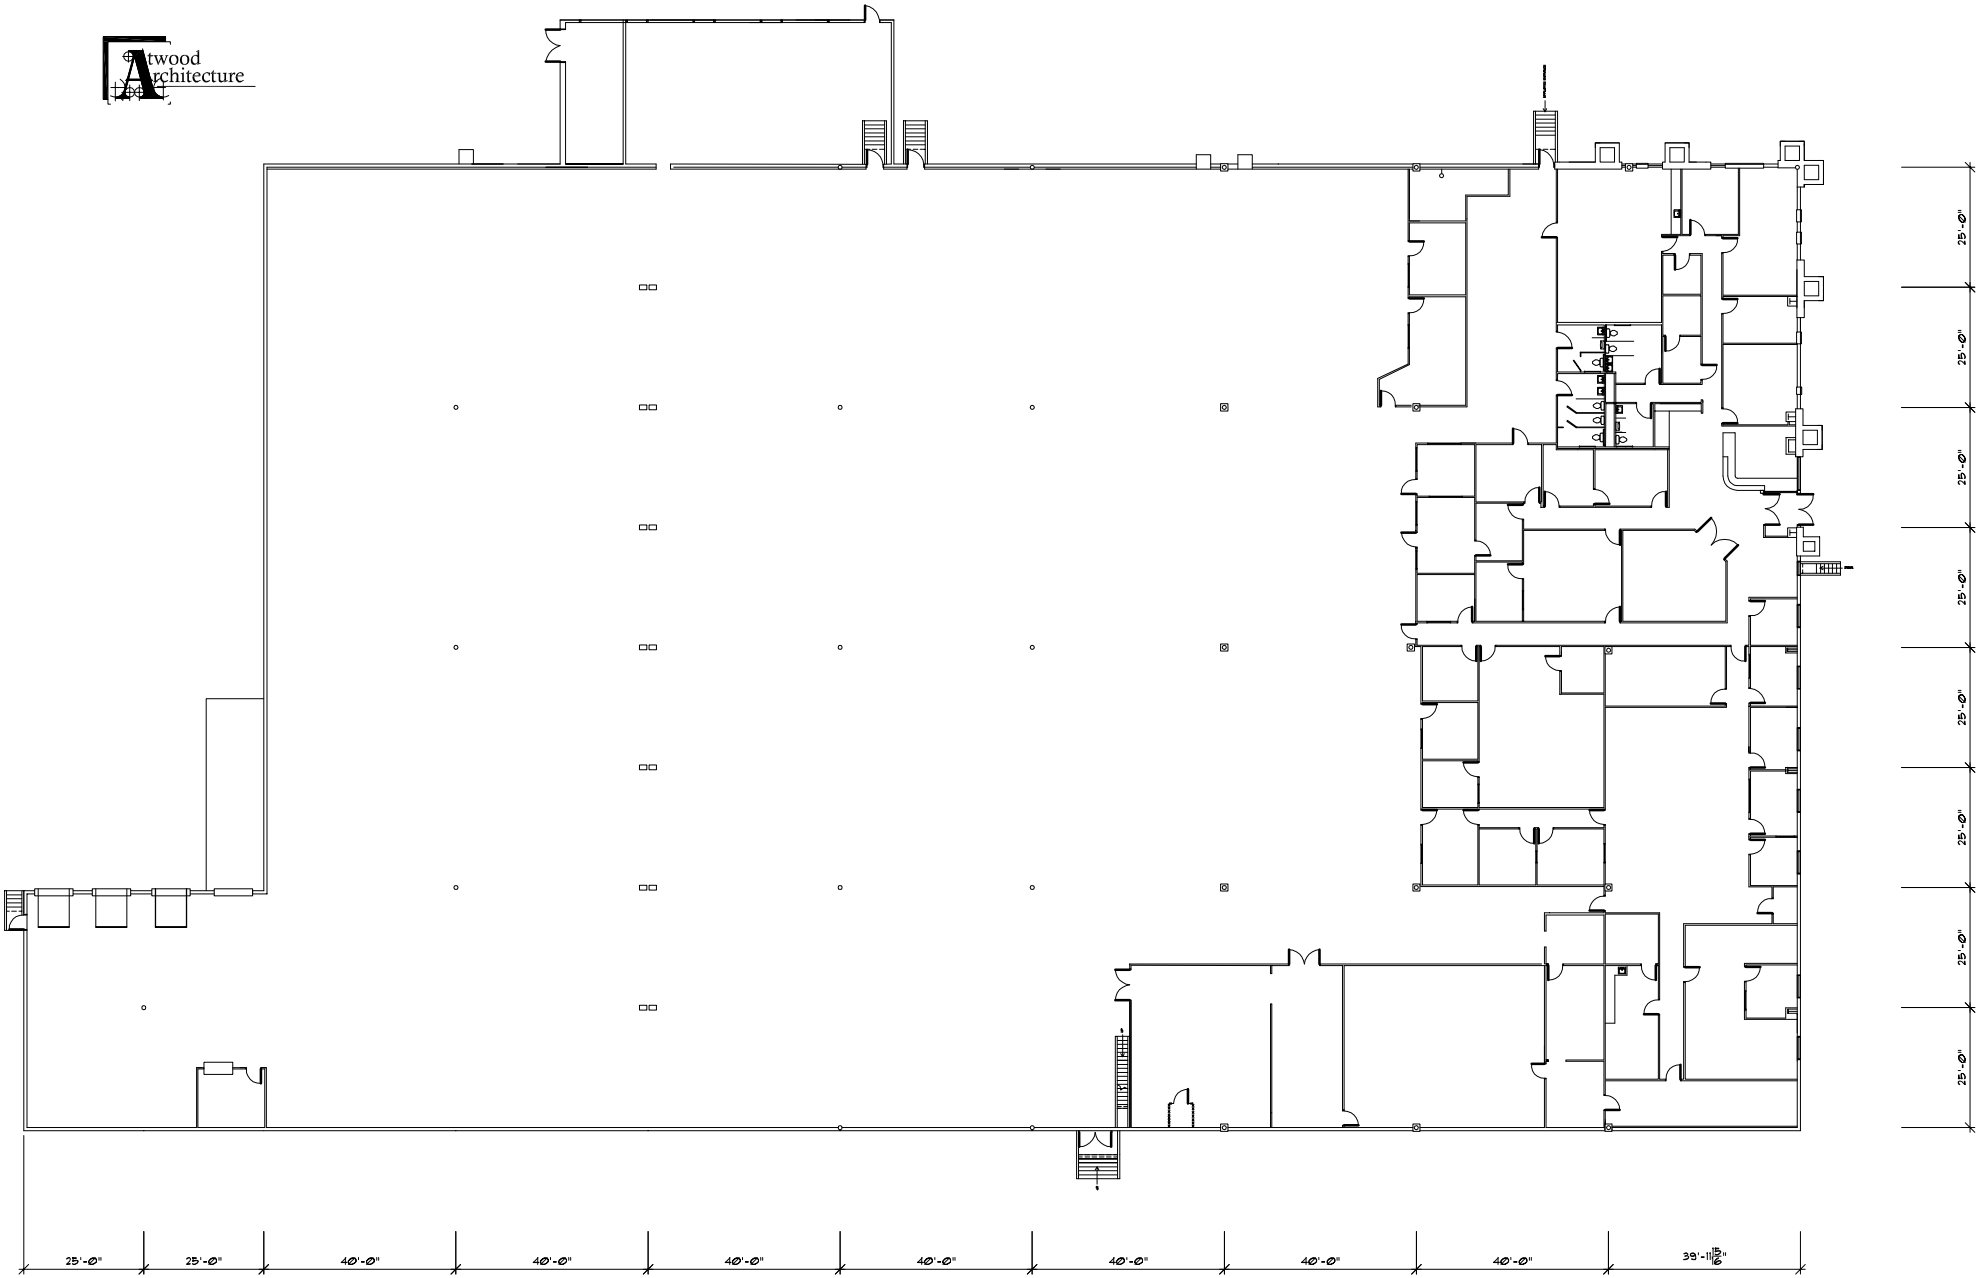

RECORD DRAWINGS OF EXISTING CONDITIONS:

SUTTON'S SPORTSWEAR

1400 SOUTH 24TH STREET WEST BILLINGS, MONTANA